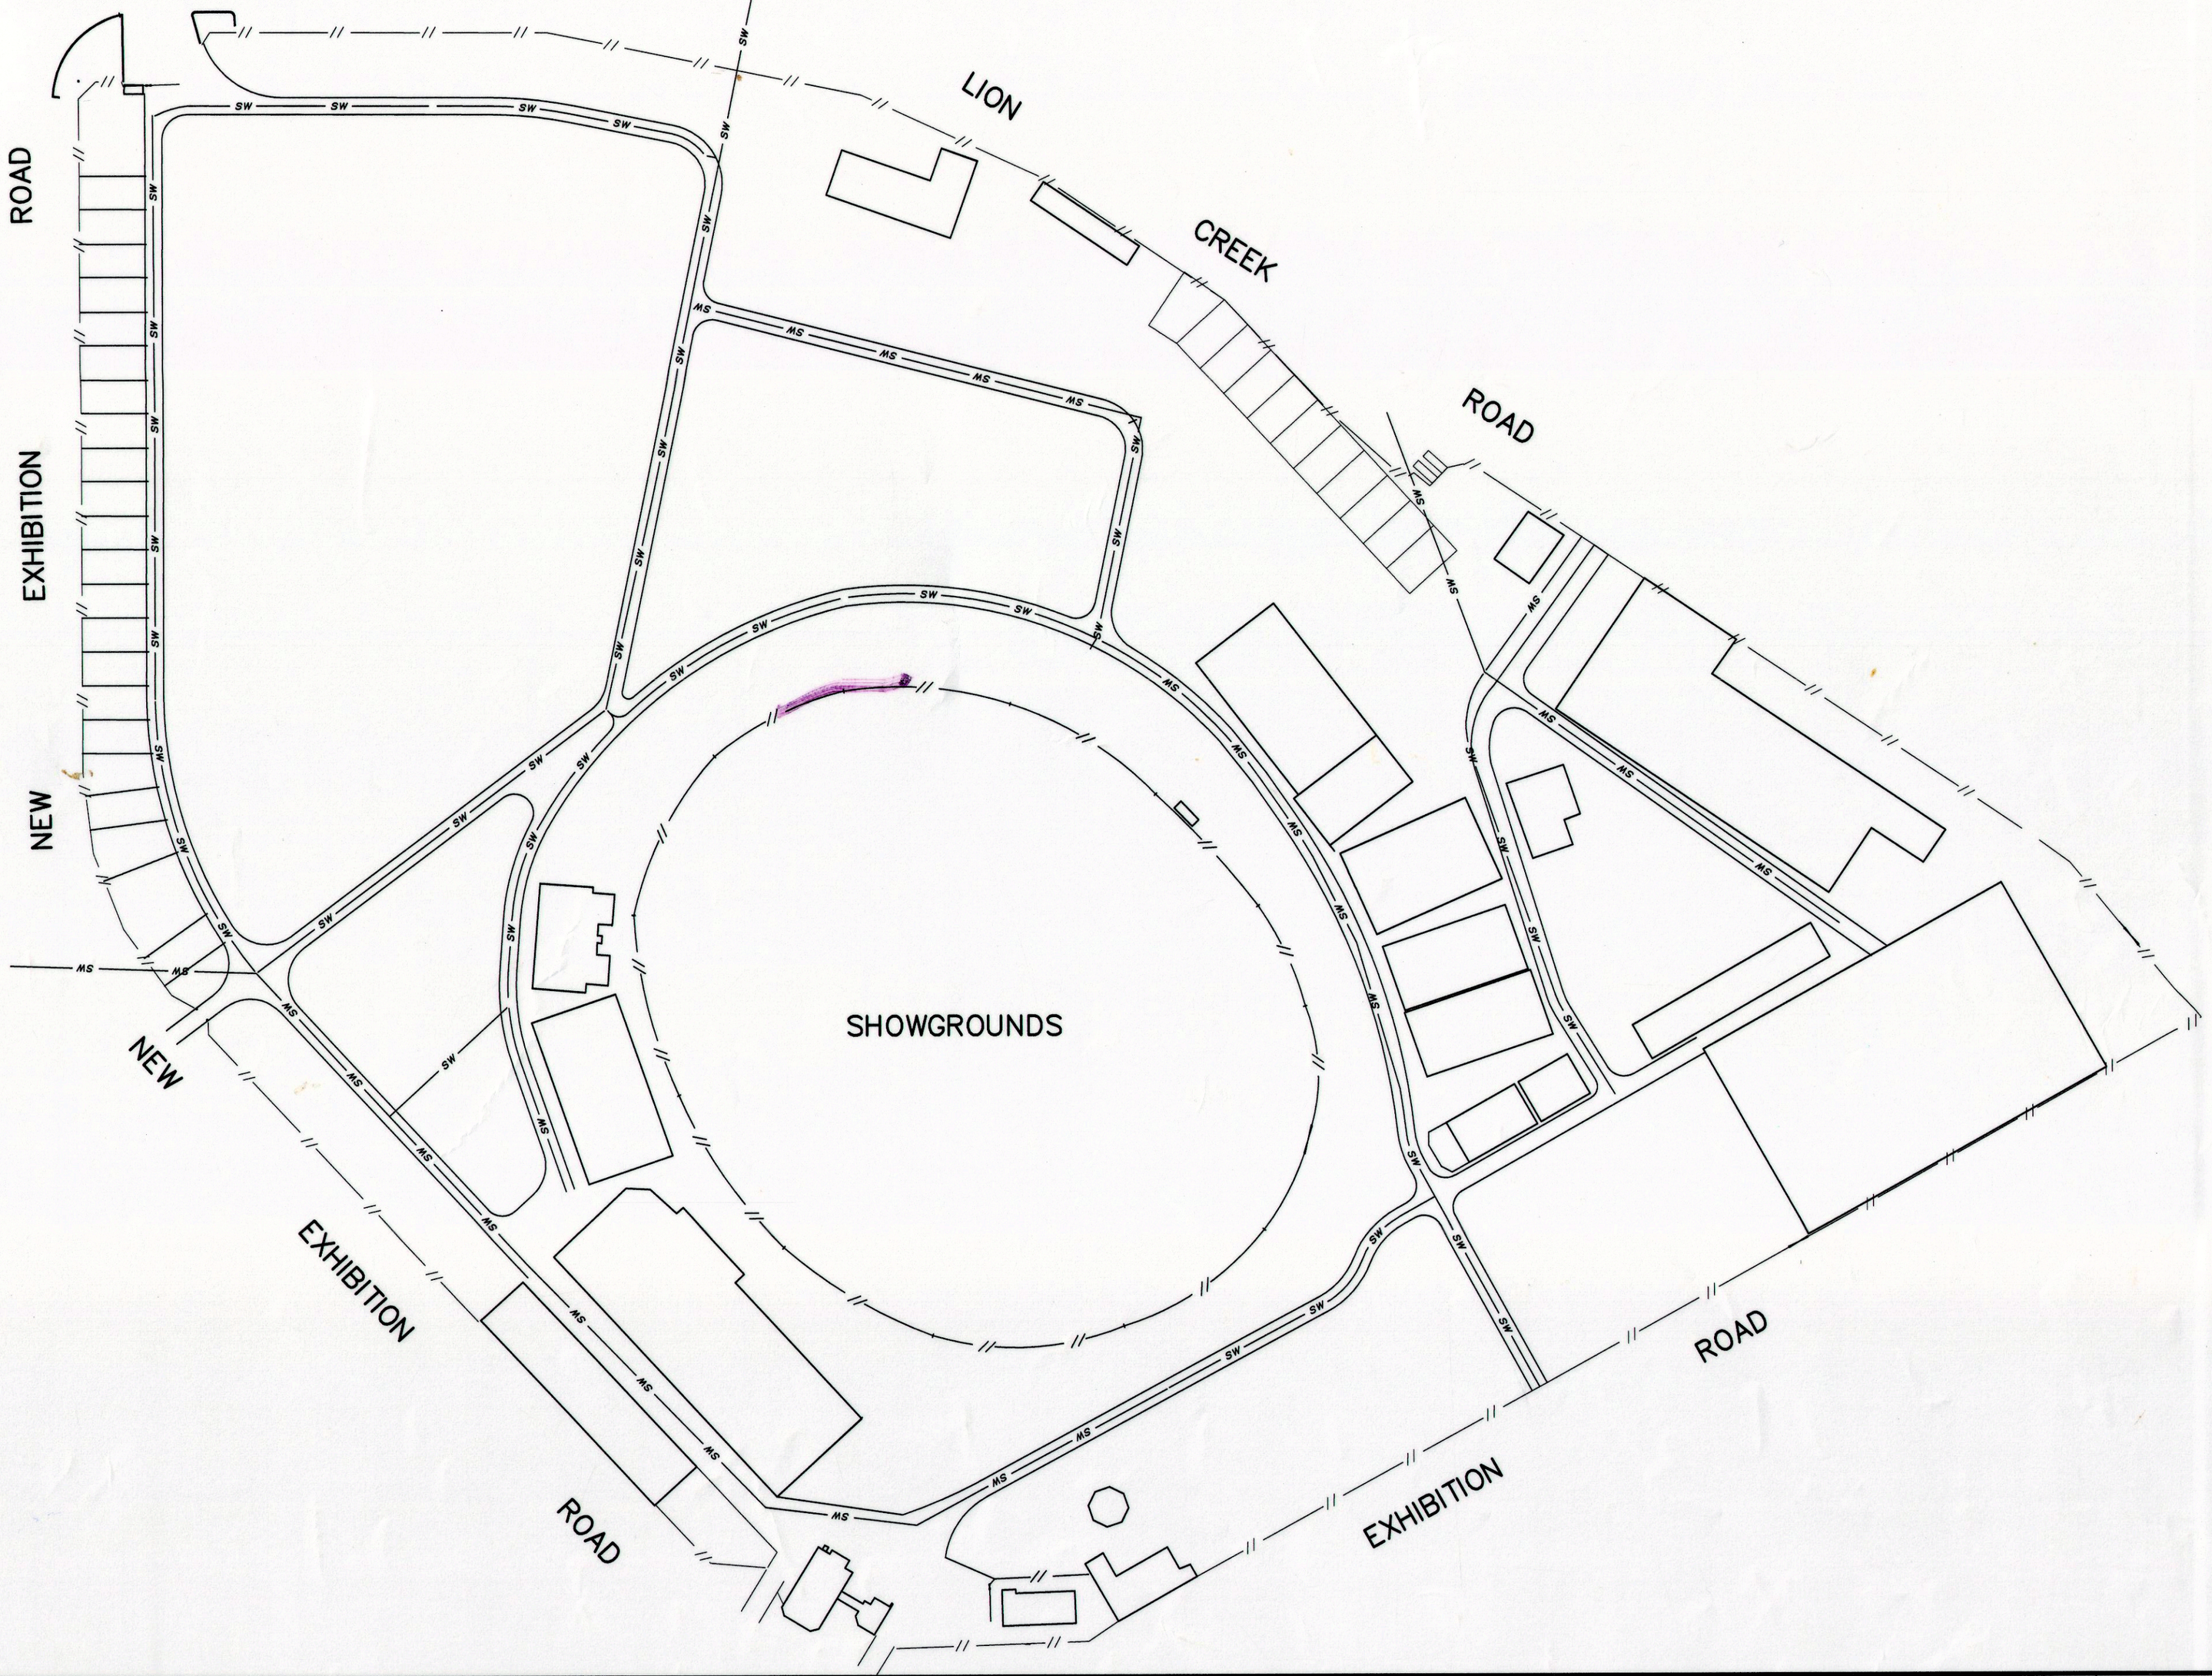

SURVEYED: SURVEYED DATE: DATE	REVISIONS	PASSED	DATE	SCALES				
SURVEY REF: SURVEYREF								
AZIMUTH DATUM: AZIMUTH								
LEVEL DATUM: LEVEL RL: RL								
DESCRIPTION: DESC								
LOCATION: LOCATION								
KEAYS FILE: KEAYS	B	AS CONSTRUCTED	3/11/03	N.T.S.	FULL SIZE A2	Drawn	M.P.	3/11/03
AUTOCAD FILE: AUTOCAD	A	ORIGINAL ISSUE	DATE			Designed		
						Checked		
						Examined		

ROCKHAMPTON CITY COUNCIL
WORKS SERVICES

APPROVED _____ Works Manager DATE _____
RPEQ No _____

ROCKHAMPTON SHOWGROUNDS
CIVIL WORKS UPGRADE
STORMWATER
LAYOUT PLAN – AS CONSTRUCTED STORMWATER

SHEET NO. 1 OF 2 PLANS
DRAWING NO.
M03-002-XX
REV. A B